



NEWDOC

**DEH APN FILE TARGET SHEET
ARCHIVE RECORD
Pre-KIVA & Existing APN Records**

Document Name: LARC_

(LARC_APN)

Document Type: Legacy Septic System Documents

APN(s) 135-101-61

Number of Pages: 9

Document Prepared by: EK

Document Preparation Date: 1-19-10

Office Source: El Cajon Ruffin San Marcos

12295



County of San Diego

DEPARTMENT OF ENVIRONMENTAL HEALTH
LAND AND WATER QUALITY DIVISION

P.O. BOX 129261, SAN DIEGO, CA 92112-8261
(619) 338-2222 FAX (619) 338-2377
1-800-253-9933

135-101-61

DATE: May 16, 02

PROJ. # T73624

INSPECTION REPORT

Final
 APPROVED

Septic System
INSPECTION TYPE

DISAPPROVED

- 1000 Gallon Norwesco poly septic tank
 - 58' leach line, 2 1/2' wide, 5' trench
 - Room for small modified pit as reserve (See As-built)
 - As-built provided
- OK to backfill

AW Brossart

1 Ba Cabin per owner

\$ 2 REINSPECTION FEE REQUIRED

SPECIALIST: Jessie Hogerwodt
PHONE: (760) 749-2902

San Diego Office
5201 Ruffin Rd., Ste. C
San Diego, CA 92123
(858) 565-5173

East County Office
200 E. Main St., 6th Flr
El Cajon, CA 92020-3912
(619) 441-4030



San Marcos Office
338 Via Vera Cruz
San Marcos, CA 92069
(760) 471-0730

SITE ADDRESS: 32762 Bielhills Dr CITY: Escondido OWNER'S NAME: William M. & Dignie, Michael


MICHAEL PIQUE
32762 BIRCH HILL RD
PALOMAR MTN.

AS-BUILT
PERMIT # T 73624
St.
May 16, 2002

APN# 135-101-61

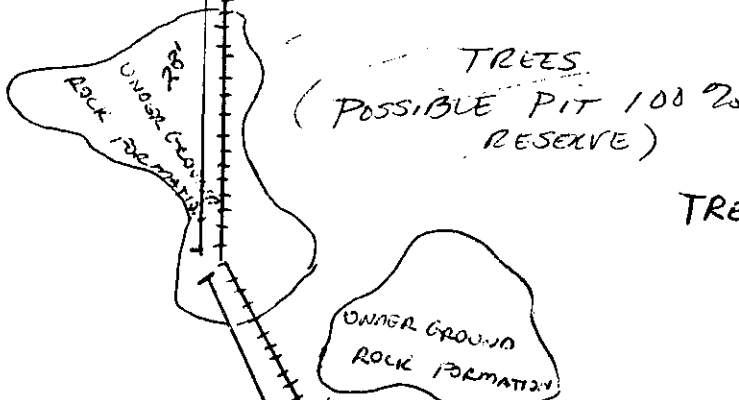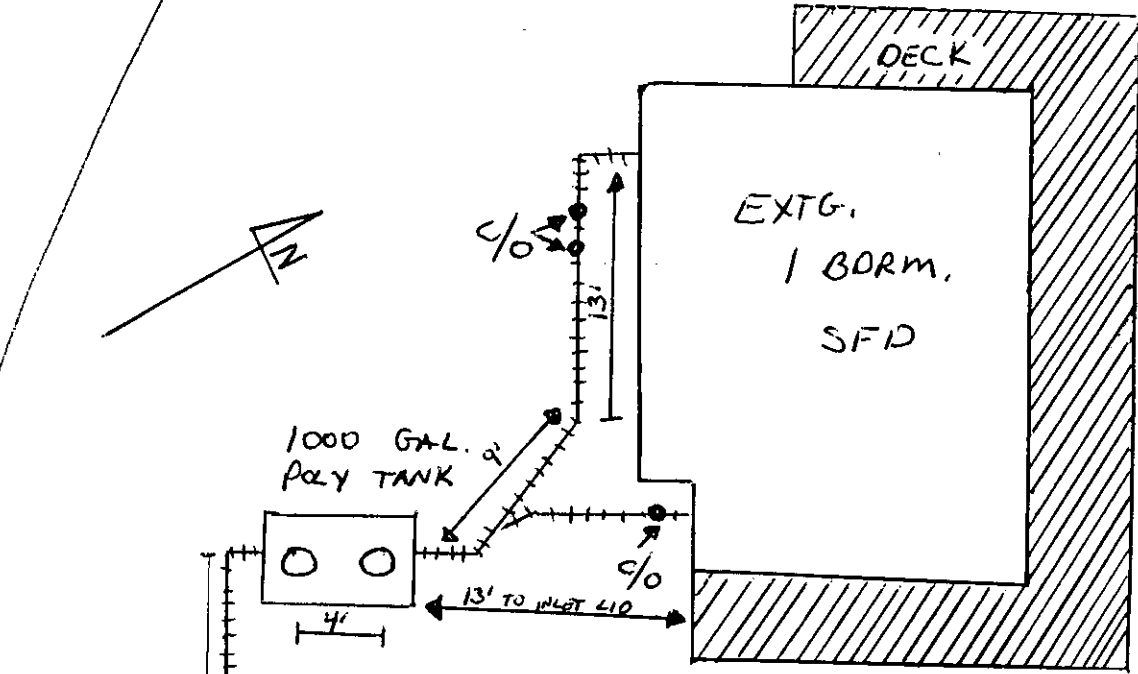

TRENCHES ARE 60" DEEP
30" WIDE
36" ROCK
● P-POLE

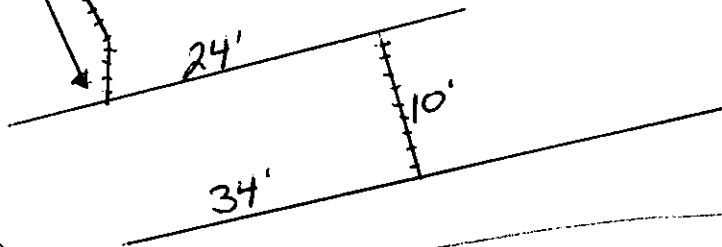



T 73624
COUNTY OF SAN DIEGO
DEPARTMENT OF ENVIRONMENTAL HEALTH
REPAIR AUTHORIZATION

Repair Authorization
R.W. Brossart
760-749-0402
30517 Rolling Hills Dr
Valley Center CA 92082

show work
Brossart

Name: MICHAEL PIQUE A.P.N.: 135-101-61
Site Address: 32762 BIRCH HILL ROAD PALOMAR MOUNTAIN
Mailing Address: 30517 ROLLING HILLS VALLEY CENTER

Check appropriate box(es): Repair Relocation Addition

- New 1000 gallon septic tank.
- Existing tank to be pumped by a licensed septic tank pumper and backfilled.
- Minimum _____ ft. leach line addition to existing system.
- Existing system to be abandoned; 83 ft. of leach line required. MODIFIED
- Laundry sump. Dimensions: _____
- Pump system. Dimensions: _____
- Other/Special Specifications: TRENCH TO BE 24" X 60" WITH 36" ROCK UNDER PIPE
- _____ ft. deep vertical seepage pit (overdrill required) with _____ ft. cap.
- _____ ft. horizontal seepage pit with _____ ft. cap.
- Supply "as built" drawing.

COMMENTS: _____

SPECIAL CONDITIONS:

- Permit issued for sewage disposal system repair purposes only. Because of site limitations, a non-standard repair has been installed that may limit the long-term performance.
- No building permits are to be approved that would increase the sewage demand on the septic system, occupancy of the structure, or encroach upon the sewage disposal system because of the limited sewage disposal area available.
- Future failure may require engineering evaluation, pumping to a higher elevation, or connection to public sewer because no additional area exists on this site for a standard repair.

[Signature]
Environmental Land Use Specialist signature

25 APR 02
Date



**PALOMAR MOUNTAIN
MUTUAL WATER CO., INC.**

To: DR. JOHN A. TAINER,
DR. ELIZABETH D. GETZOFF AND MR. MICHAEL E. PIQUE

4690 Monongahela Street
San Diego, CA 92117

(619)

Date: January 11, 1999

Subject: New Watershare Certificate

Dear New Shareholder:

Enclosed please find your PMMWCo Certificate referencing


135-101-24, 135-101-61
APN 135-101-26 - 135-101-23

Also enclosed are the ByLaws, a current list of rates and regulations and a recent newsletter. Membership meetings are held annually on Labor Day.

Please keep your Certificate in a safe place. It is a valuable document. It will be necessary to turn it in to the PMMWCo if you sell your property or if you buy additional property which has a water unit issued by PMMWCo.


If you have any questions, please leave me a message at the PMMWCo office.

Sincerely,
Board of Directors

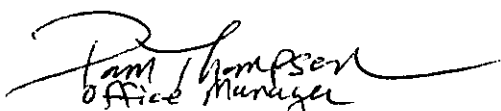
Office Manager
Secretary

APN# 135-101-61.

MICHAEL PIQUE
32762 BIRCH HILL ROAD
PALOMAR MOUNTAIN

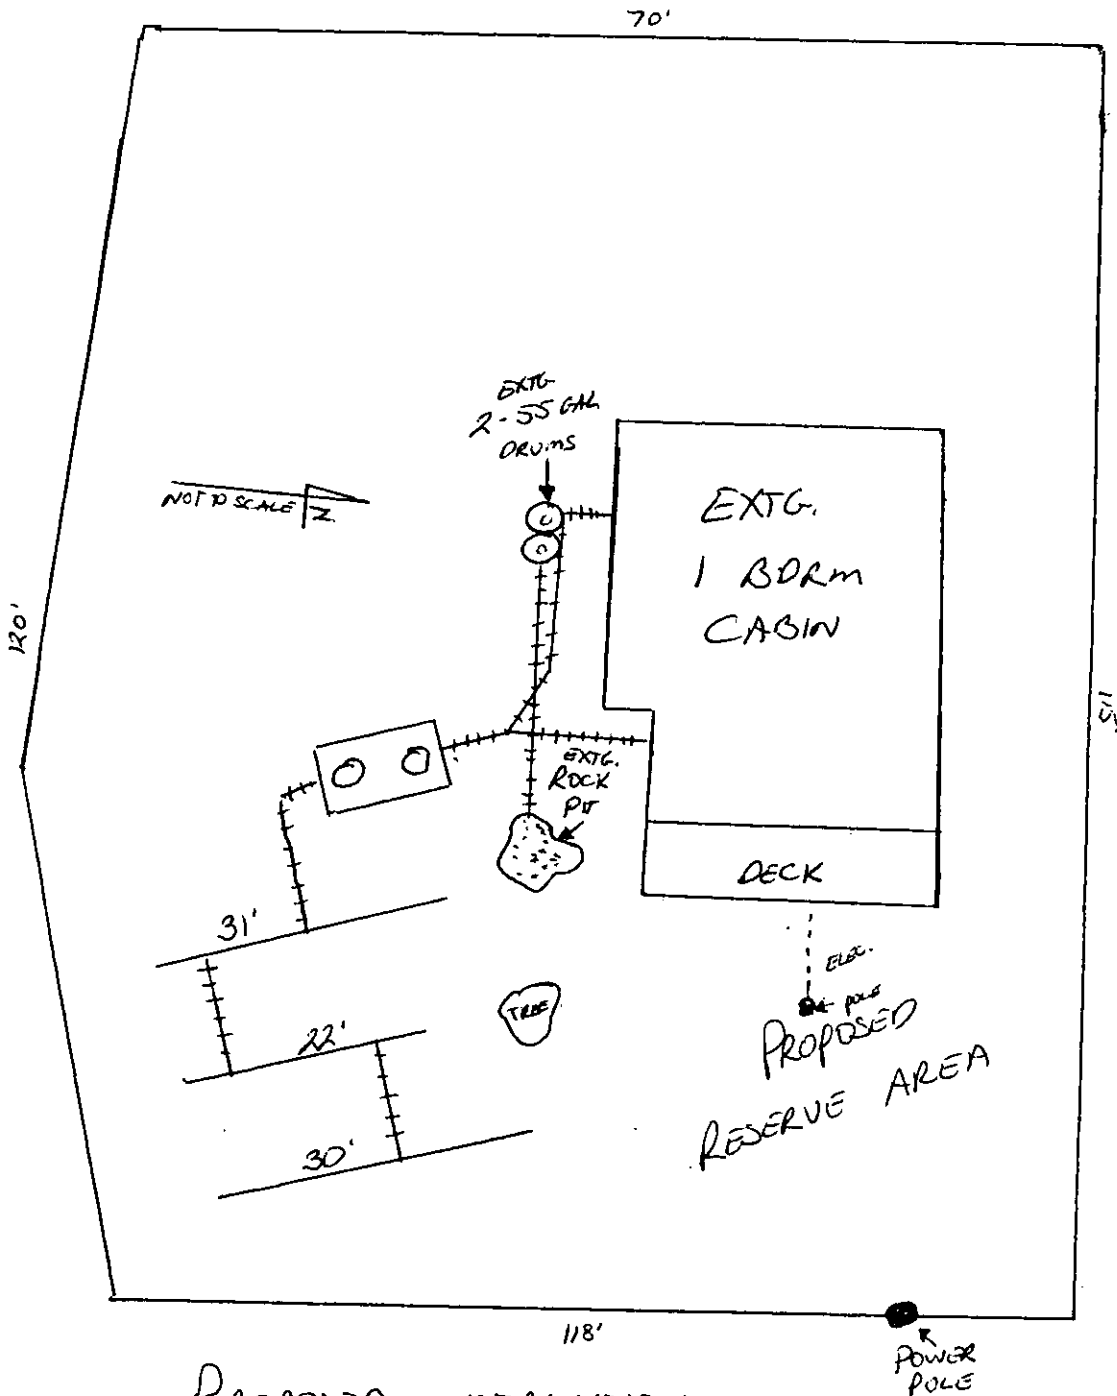

PROPOSED INSTALLATION

1000 GAL. POLY TANK

83 FEET OF MODIFIED TRENCH - 24" WIDE, 60" DEEP

36" ROCK UNDER PIPE (= 612.8 CU. FT. - 200' STD TRENCH = 611.2 CU. FT.)

PERMIT FOR SEPTIC TANK SYSTEM
EXPIRES ONE YEAR FROM DATE OF ISSUE

PERMIT ISSUED SC
BY:

DATE: 4-25-2002

T 73624

NAME OF OWNER PIQUE, MICHAEL	OWNER'S MAILING ADDRESS 30517 ROLLING HILLS, VALLEY CENTER, 92082	PHONE
ADDRESS OR LOCATION OF JOB 32762 BIRCH HILL RD., PALOMAR MOUNTAIN, CALIFORNIA 92060		
ASSESSOR'S PARCEL NUMBER 135-101-61	SEPTIC TANK CONTRACTOR CENTER SEPTIC	PHONE 760-749-0402

SPACE BELOW FOR DEPARTMENTAL USE ONLY

E11 190

PERMANENT <input checked="" type="checkbox"/> TEMPORARY <input type="checkbox"/>	LAYOUT APPROVAL: PERCOLATION TEST _____
SEPTIC TANK 1000 GALLON	PIERCE SUBDIVISION _____
LEACH LINE _____	SPECIALIST C/C B/A P/M _____
SEEPAGE PIT _____	DATE 4-25-02 FIELD APPROVAL _____
REMARKS SEE NOTES REPAIR AUTHORIZATION	REPAIRS _____
WATER SOURCE EXISTING	OCCUPANCY: COMMERCIAL <input type="checkbox"/> RESIDENTIAL <input checked="" type="checkbox"/> BD EXISTING _____

REQ 04-25-02
SMC: JHM
REPAIRS
OCCUPANCY

DATE REQUESTED	DATE INSPECTED	APPROVED	DISAPPROVED	PENDING	EXPIRED STATUS	FINAL APPROVAL
5/16/02	5/16/02	<i>DA</i>		12-4-99-1		<i>Stogewurst</i>

✓ # 1382

DISTRIBUTION: White - DEH Layout Green - Owner Yellow - DEH Ruffin Road Pink - DEH Cashier Goldenrod - DEH Office

DEH:LU-701 (Rev. 9/97) NCR

190.00
2170.00
5154
1015

County of San Diego Department of Environmental Health
P.O. Box 129261, San Diego, CA 92112-9261



I hereby certify that I am the owner of the property for which I am applying for a permit to construct a subsurface sewage disposal system. I do not intend to sell or offer for sale this property within one year after completion of construction. I therefore request an exemption from the requirement that I have a proper contractor's license for such construction.



I hereby certify that I am a contractor licensed in the State of California, to perform the specific tasks for which I am presently applying. My license is in full force and effect, and will remain so to the best of my knowledge throughout the duration of this project. My contractor's license is, as follows:

1. In the name of R.W. Brossart
2. State License No. CA # 790472
3. Classification A
(Class A or C42 required per Business & Professional Code, Chapter 9, Sec. 7056, and Calif. Administrative Code, Chapter 8 T-16, Sec. 754.4)

I am informed and understand that any false information would result in a penalty of not more than \$500 for each violation, as provided in Business and Professional Code, Sec. 7031.5.

Signed Imona Brossart Date 4/20/02